


F.H.W.A. REGION NO.	STATE	FED. AID PROJ. NO.	SHEET NO.	TOTAL SHEETS
3	MD.			

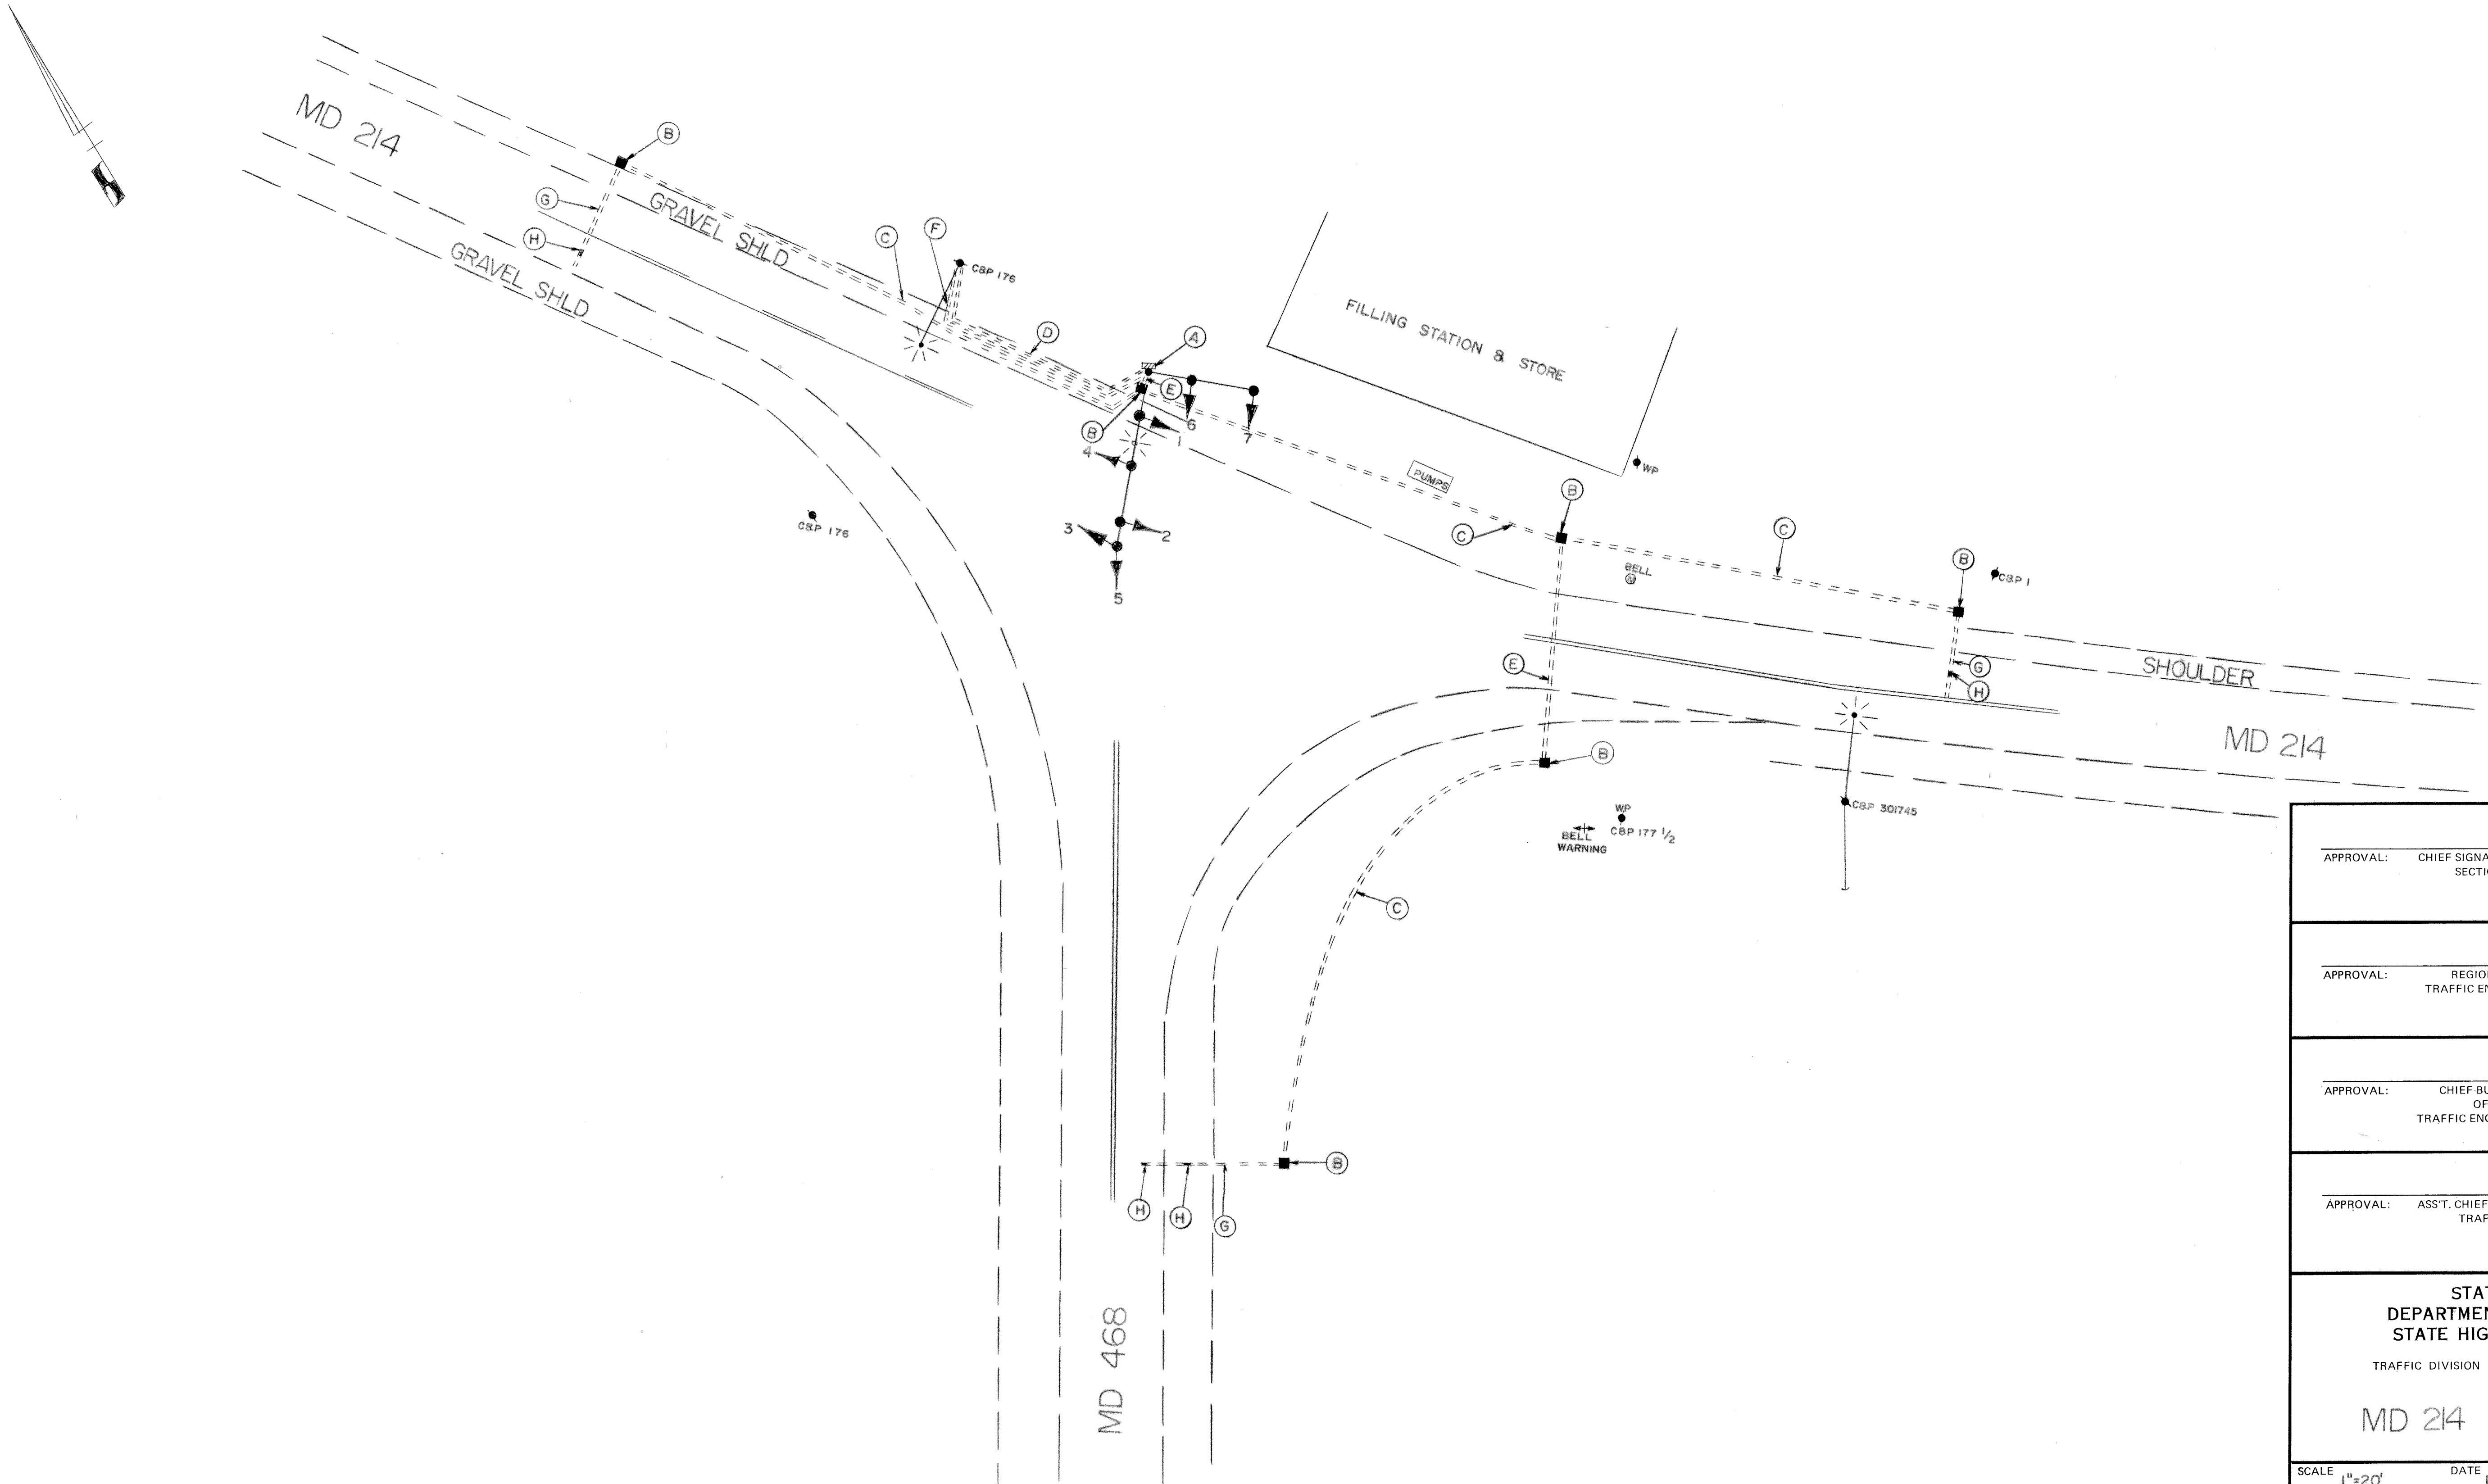

APPROVAL: CHIEF SIGNAL DESIGN SECTION	
APPROVAL: REGIONAL TRAFFIC ENGINEER	D REDRAWN 10-18-82
APPROVAL: CHIEF-BUREAU OF TRAFFIC ENGINEERING	JH C ASBUILT 6-28-82
APPROVAL: ASS'T. CHIEF ENGINEER TRAFFIC	LES B CHANGED LOOP DET TO MAGNETIC DET 3-31-82
	LET A ADDED 2" GALV CONDUIT FOR ST LIGHT 12-29-70
	JS REVISIONS

STATE OF MARYLAND DEPARTMENT OF TRANSPORTATION STATE HIGHWAY ADMINISTRATION TRAFFIC DIVISION - BUREAU OF TRAFFIC ENGINEERING		
MD 214 & MD 468		
SCALE 1"=20'	DATE 10-18-82	CONTRACT NO. AA 788X-575
DRAWN BY: J HOYAS WFF	COUNTY: ANNE ARUNDEL	
DESIGNED BY:	SIGNAL NO.: 02121	
CHECKED BY:	DRAWING NO. TS-125 D	